
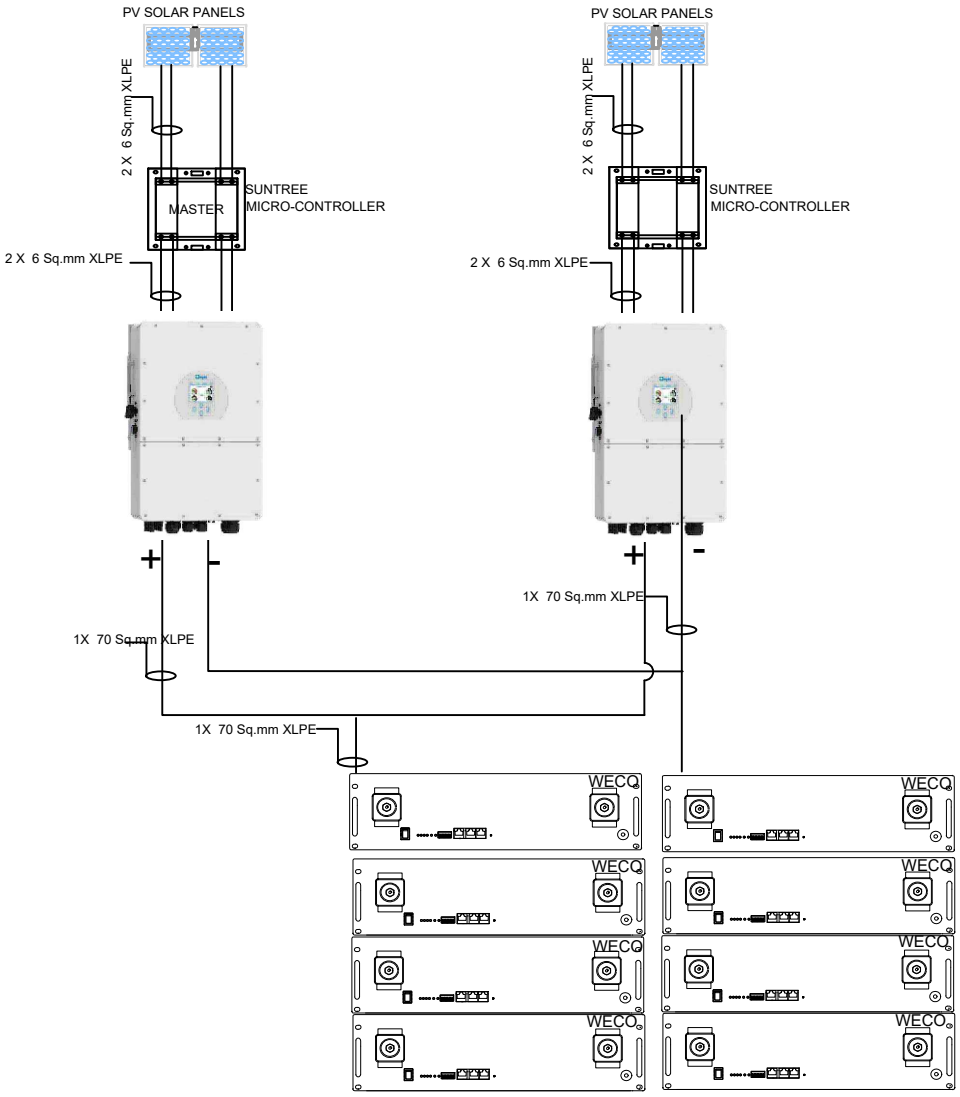


TAWANE SOLUTIONS LTD Sustainable. Smart. Proven		STAMP:	TITLE: AS BUILT SOLAR PANEL INSTALLATION	DRAWN BY: M.M APPROVED BY: A.N	SCALE: 1:100	P.S A3
			PROJECT: PROPOSED SOLAR INSTALLATIONS	DATE: 31/8/2026	Sh.No: 001	
			CLIENT:	QUOTE REF:	Drg.No: 001	

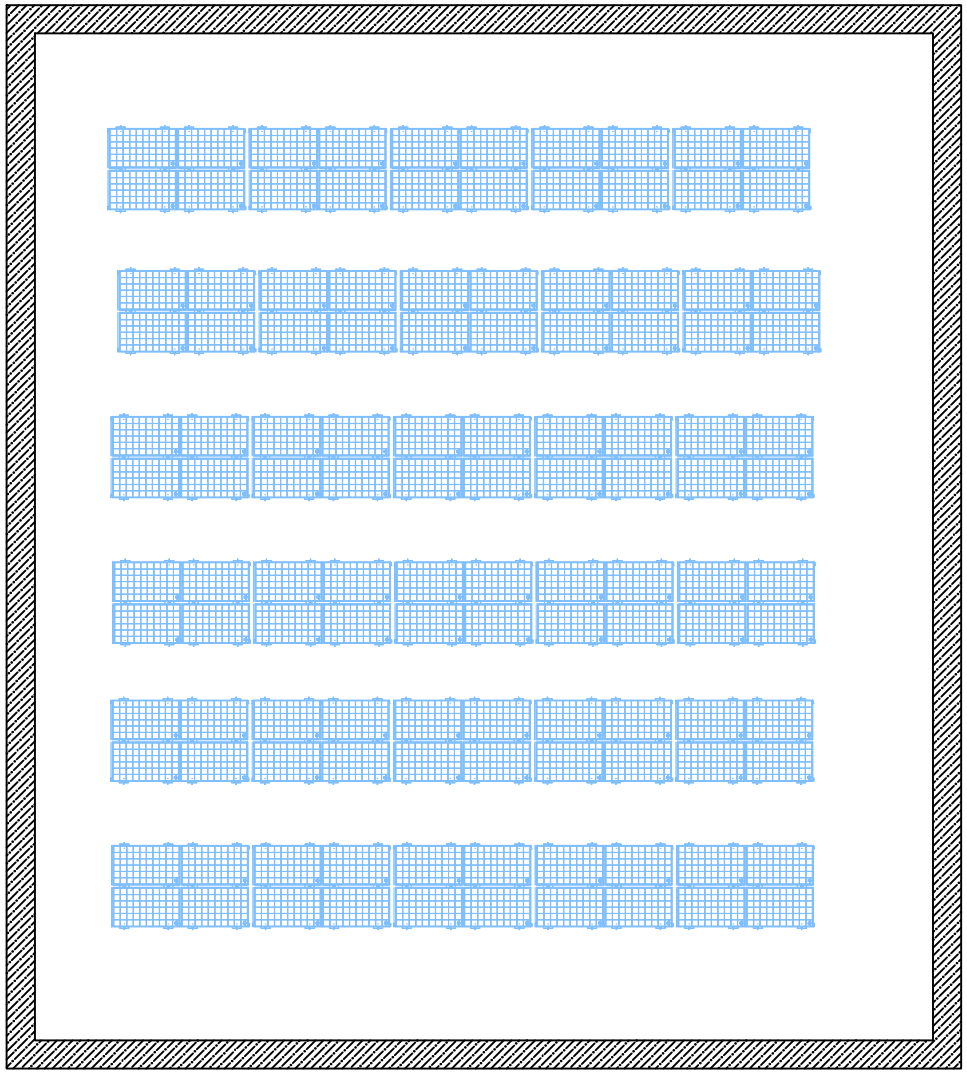

TAWANE SOLUTIONS LTD Sustainable. Smart. Proven	STAMP:	TITLE: AS BUILT SOLAR PANEL INSTALLATION	DRAWN BY: M.M APPROVED BY: A.N	SCALE: 1:100 P.S A3
		PROJECT: PROPOSED SOLAR INSTALLATIONS	DATE: 31/8/2026	Sh.No: 001
		CLIENT:	QUOTE REF:	Drg.No: 001